

NOTES
 -ALL STORMWATER PIPES ARE RCP '2' U.N.O.
 -ALL STORMWATER PVC PIPES ARE CLASS '8' U.N.O.

Works As Constructed
 It is certified that the locations, Levels and dimensions of the infrastructure shown herein are a true representation of the constructed works and that the As-Constructed survey was performed to the prescribed accuracy standards.

Authorised Delegate..... *C. Walter*
 Date..... 1/09/2023
 LandPartners Pty Ltd (ACN 118 146 008) Surveyor No. S4118

Works As Constructed
 It is certified that works herein have been constructed to Local Government standards, relevant approved specifications and the operational works approval. The As-Constructed Drawings for these works constitutes a true and correct record of the works constructed and complies with the design intent.

Signature..... RPEQ No.....
 Date of Practical Completion.....
 Engineering Consultant.....



ISSUE	DATE	AUTHOR	COMMENTS
1	21/04/2022	BJB	INITIAL ISSUE
2	12/07/2022	BJB	AMENDED ISSUE
3	03/08/2022	BJB	AMENDED ISSUE
4	11/08/2022	BJB	AMENDED PIPE DIAMETER
5	03/11/2022	BJB	AMEND EASEMENTS
6	10/05/2023	MJK	ADDED HOUSE CONNECTIONS

ISSUE	DATE	AUTHOR	COMMENTS
7	1/09/2023	MJK	LOT 4 ROOFWATER CONNECTION ADDED



CLIENT
ECONOMIC DEVELOPMENT QUEENSLAND

PROJECT
OXLEY SECONDARY COLLEGE REDEVELOPMENT STAGE 1 AS CONSTRUCTED STORMWATER DEV2020/1099

ENGINEERING CONSULTANT
KN GROUP

LGA/SERVICE PROVIDER
BRISBANE CITY COUNCIL

0 10 25 55m
 SCALE 1:500

SHEET 1 of 2		
DATUM	AHD	LEVEL ORIGIN
CONTOURS	N/A	FILE NO. BRSS7460-001-111-8
DRAWN	MJK	DATE 1/09/2023
CHECKED	CGW	DATE 1/09/2023
APPROVED	RA	DATE 1/09/2023
PLAN NUMBER	BRSS7460-001-112-7	



NOTES
 -ALL STORMWATER PIPES ARE RCP '2' U.N.O.
 -ALL STORMWATER PVC PIPES ARE CLASS '8' U.N.O.

Works As Constructed
 It is certified that the locations, Levels and dimensions of the infrastructure shown herein are a true representation of the constructed works and that the As-Constructed survey was performed to the prescribed accuracy standards.

Authorised Delegate..... *C. Walter*
 Date..... 1/09/2023
 LandPartners Pty Ltd (ACN 118 146 008) Surveyor No. S4118

Works As Constructed
 It is certified that works herein have been constructed to Local Government standards, relevant approved specifications and the operational works approval. The As-Constructed Drawings for these works constitutes a true and correct record of the works constructed and complies with the design intent.

Signature.....RPEQ No.....
 Date of Practical Completion.....
 Engineering Consultant.....

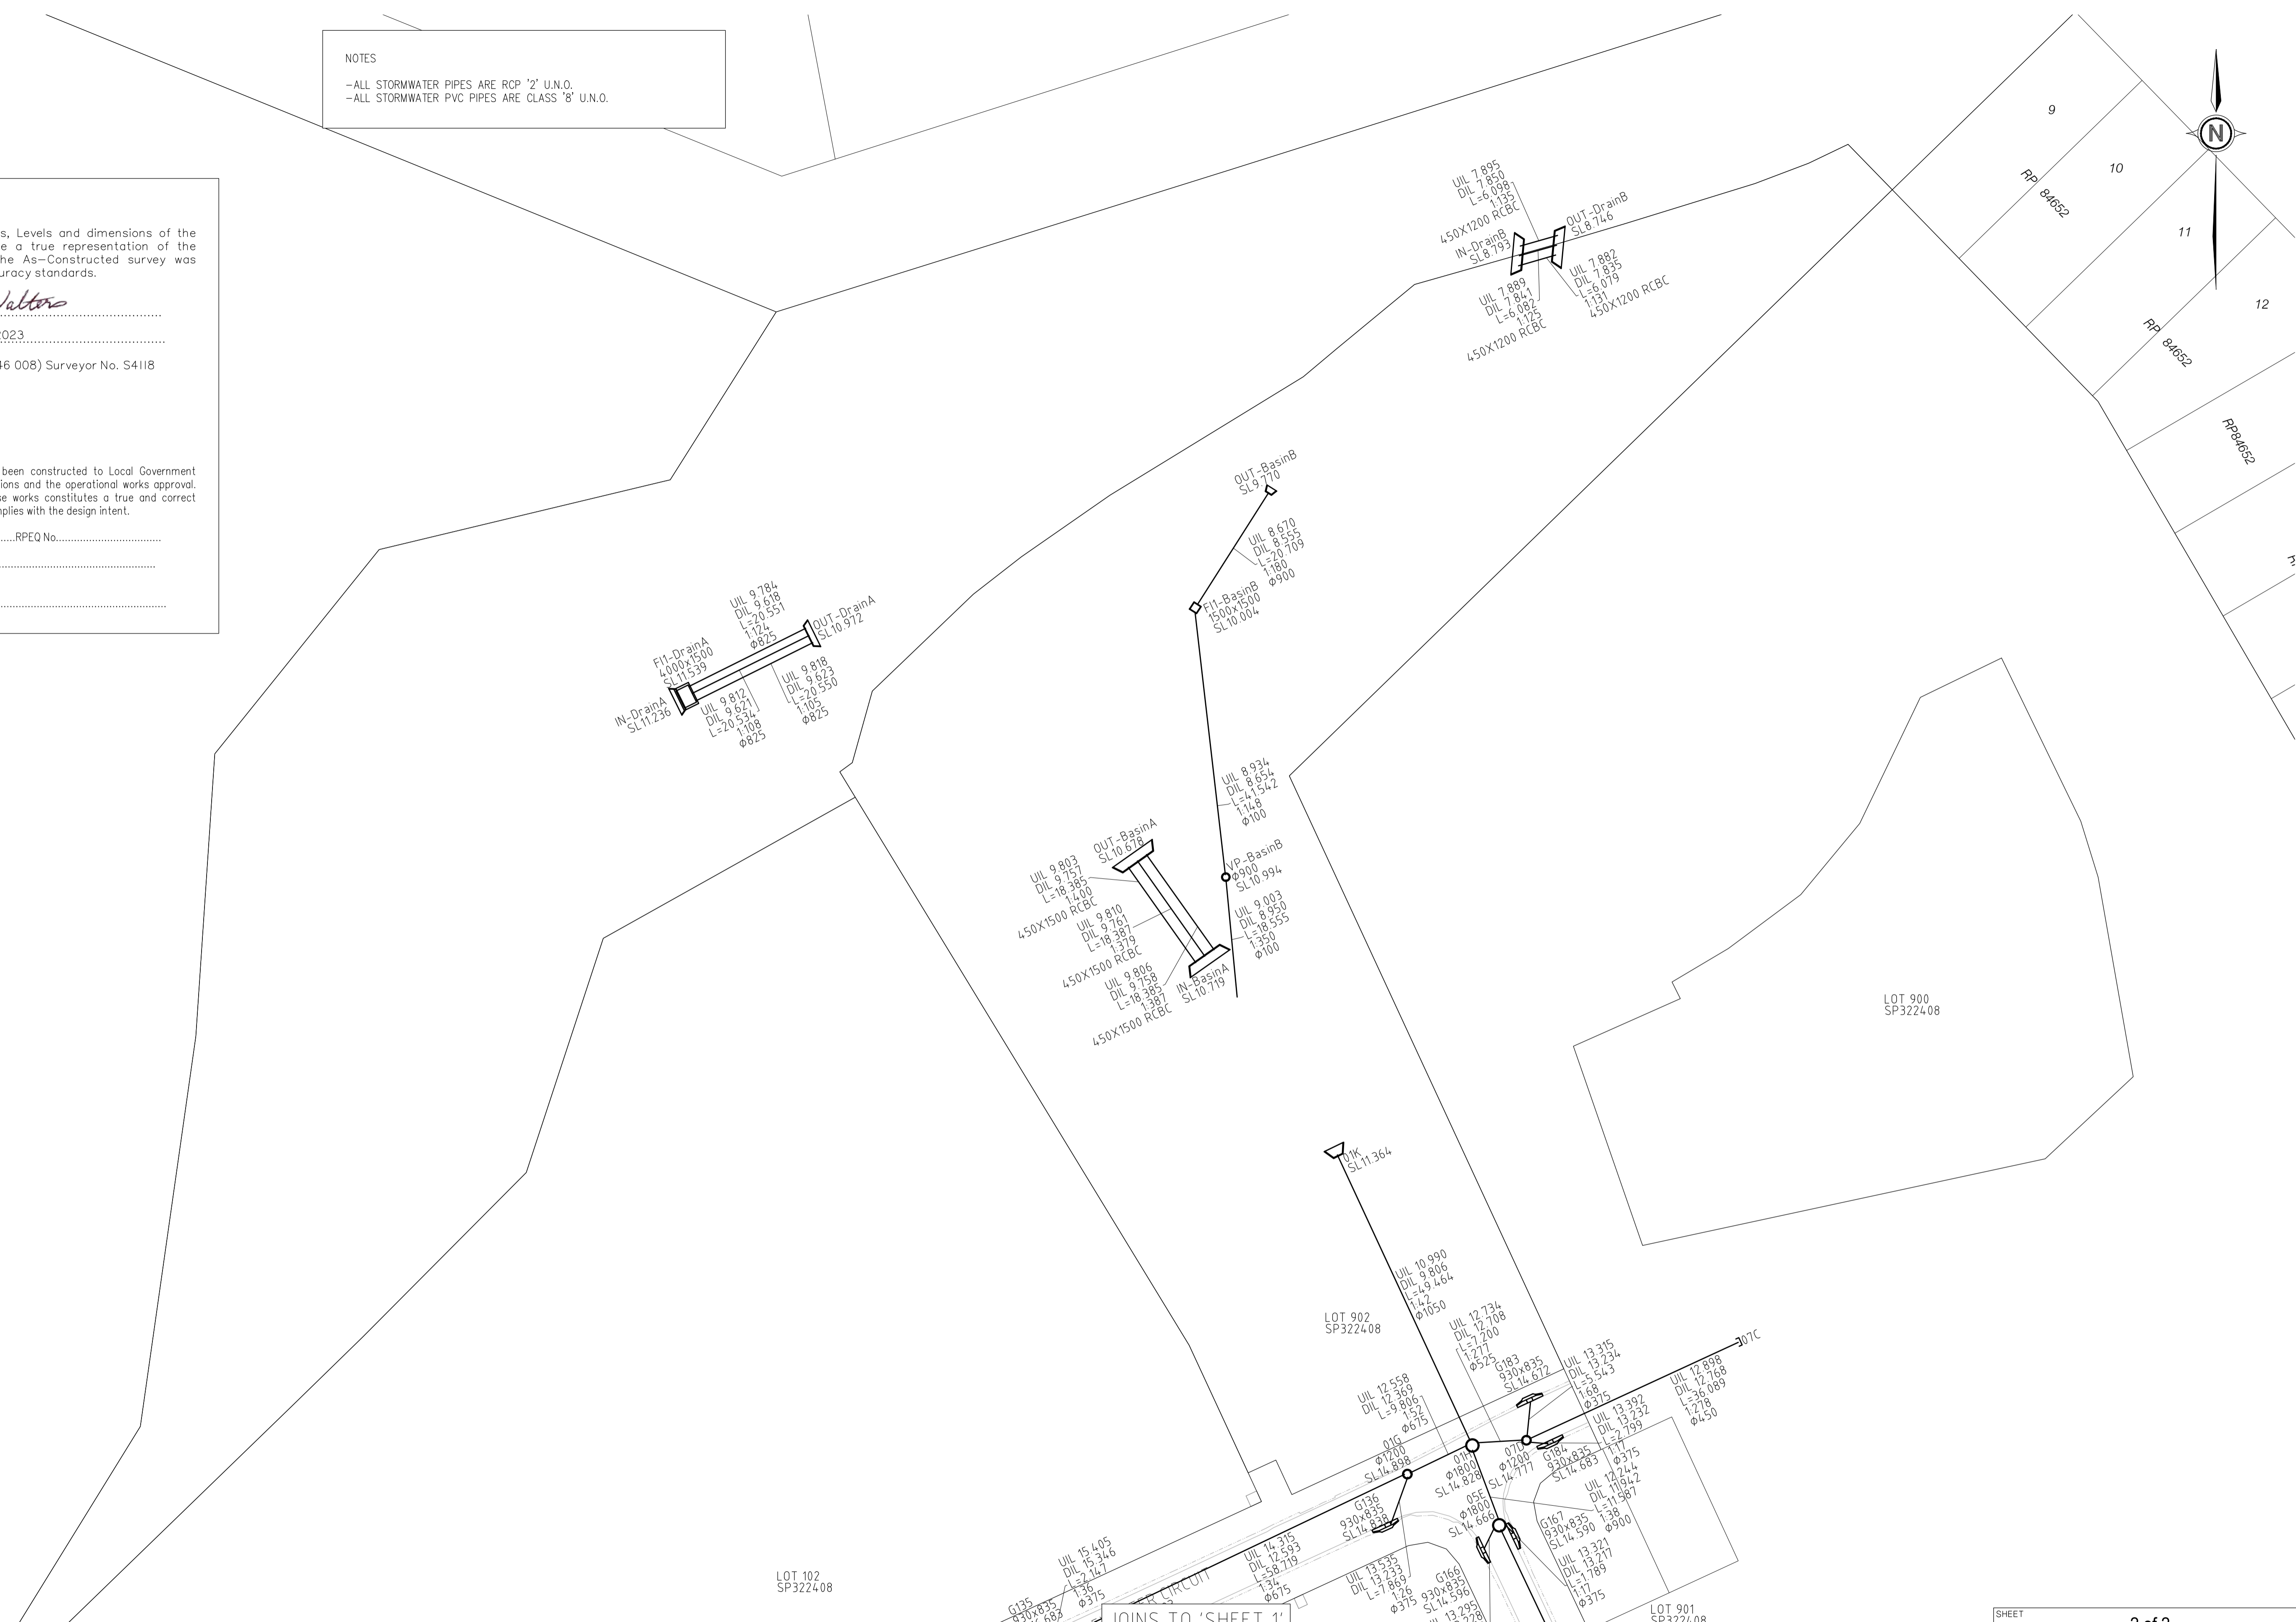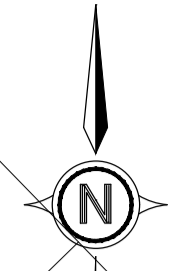

A1

ISSUE	DATE	AUTHOR	COMMENTS	ISSUE	DATE	AUTHOR	COMMENTS
1	21/04/2022	BJB	INITIAL ISSUE	7	1/09/2023	MJK	LOT 4 ROOFWATER CONNECTION ADDED
2	12/07/2022	BJB	AMENDED ISSUE				
3	03/08/2022	BJB	AMENDED ISSUE				
4	11/08/2022	BJB	AMENDED PIPE DIAMETER				
5	03/11/2022	BJB	AMEND EASEMENTS				
6	10/05/2023	MJK	ADDED HOUSE CONNECTIONS				



CLIENT
ECONOMIC DEVELOPMENT QUEENSLAND

PROJECT
**OXLEY SECONDARY COLLEGE
 REDEVELOPMENT STAGE 1
 AS CONSTRUCTED STORMWATER
 DEV2020/1099**

ENGINEERING CONSULTANT
KN GROUP

LGA/SERVICE PROVIDER
BRISBANE CITY COUNCIL

0 10 25 55m
 SCALE 1:500

SHEET			2 of 2		
DATUM	AHD	LEVEL ORIGIN			
CONTOURS	N/A	FILE NO.	BRSST460-001-111-8		
DRAWN	MJK	DATE	1/09/2023		
CHECKED	CGW	DATE	1/09/2023		
APPROVED	RA	DATE	1/09/2023		
PLAN NUMBER			BRSS7460-001-112-7		