


LEGEND

- (FH) FIRE HYDRANT
- ⊗ (VS) STOP VALVE
- ⊗ (VA) SCOUR ASSEMBLY
- (TB) TAPPING BAND
- ⊗ (WM) WATER METER (SEQ 20φ)
- END CAP
- ⊕ TEE
- ⋖ (RE) REDUCER
- BEND
- DICL WATER MAIN CROSSING
- - - CONDUIT/CROSSING
- EXISTING WATER

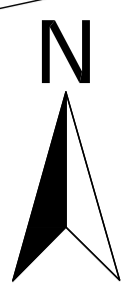

NOTES

- ALL WATER RETICULATION PIPES ARE PE-100 PN16 U.N.O.
- ALL WATER MAIN DICL PIPES ARE PN35 U.N.O.
- ALL WATER SERVICE CROSSING PIPES ARE #100 PVC PN9 U.N.O.
- ALL FIRE HYDRANTS ARE #100 SPRING U.N.O.

REGISTERED SURVEYOR'S CERTIFICATION

.....LANDPARTNERS PTY LTD..... hereby certify that the vertical and horizontal locations and dimensions shown on this plan are a true and correct record and were located by survey.


Rosa McDowall (DIRECTOR)
LandPartners Pty Ltd, Reg. Surveyor No. S4118 Date: 24/03/2022

ENGINEERS CERTIFICATION


I,, hereby certify that:

1. The information contained in this drawing / document is in compliance with approved drawings and design.
2. The new water and sewerage works defined by this drawing have been designed and constructed in accordance with the SEQ Code.
3. This represents an accurate record of as-constructed works.
4. I accept responsibility for the information contained in this drawing / document.

RPEQ (signature) _____ RPEQ No. _____ Date: _____

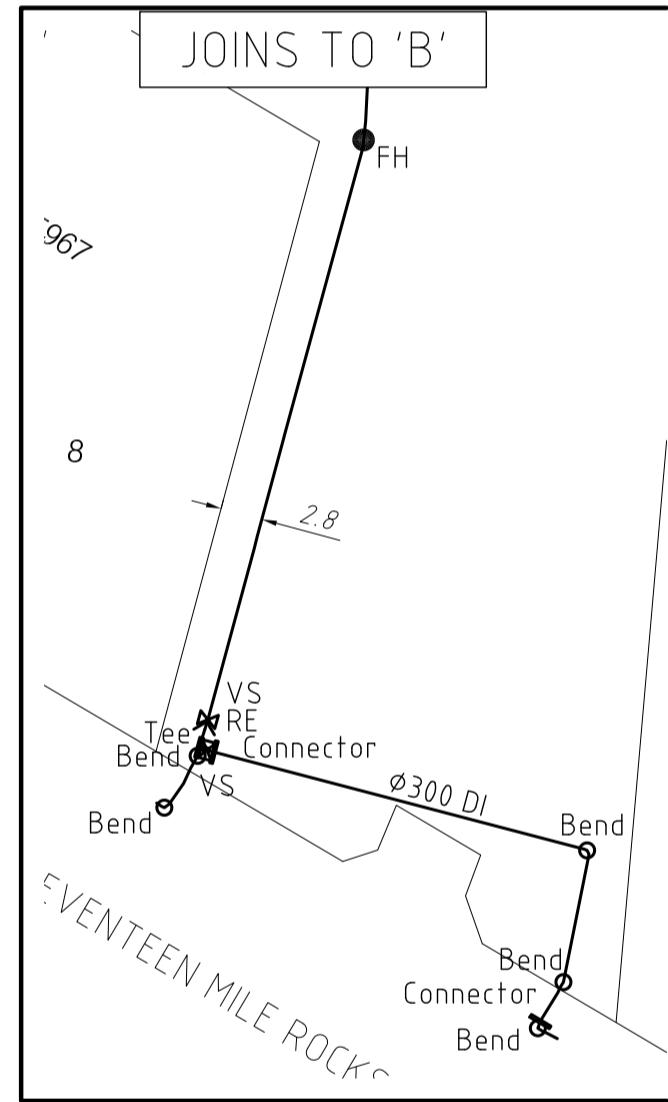

AS CONSTRUCTED

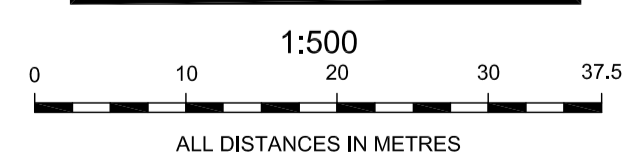

A1									
	2	24/03/2022	AMENDED ISSUE	B.B	R.A	R.A	R.A	R.A	R.A
	1	09/02/2022	INITIAL ISSUE	B.B	R.A	R.A	R.A	R.A	R.A
	INDEX	DATE	REVISIONS	DRAWN	CHECKED	PASSED	INITIALS	DATE	PASSED

DRAWN	B.B	24/03/2022	CHECKED	R.A
PASSED	R.A	24/03/2022	PASSED	R.A
INITIALS	DATE	DATE	INITIALS	DATE

LANDPARTNERS
built environment consultants

QUEENSLAND
UrbanUtilities

Queensland Urban Utilities

OXLEY PDA STAGE 1
AS CONSTRUCTED WATER
DEV2020/1099

SCALE 1:500
SHEET 1 OF 1 SHEETS
DRAWING NO.
BRSS7460-001-95-2